

RESOLUTION NO. 33-18
A RESOLUTION OF CONCURRENCE
REGARDING REVISIONS TO THE NATIONAL HIGHWAY SYSTEM (NHS)
IN THE MACOG PLANNING REGION

WHEREAS, the Michiana Area Council of Governments (MACOG) being the duly designated Metropolitan Planning Organization (MPO) for the South Bend and Elkhart/Goshen Urbanized Areas, in cooperation with local governmental units and implementing agencies within the urbanized areas; and

WHEREAS, the MPO function is to efficiently administer regional planning programs for the Transportation Management Area (TMA), which encompasses all of Elkhart and St. Joseph Counties, Indiana. MACOG, as the Council of Governments, represents four counties: two urban counties; St. Joseph and Elkhart Counties, and two rural counties; Kosciusko and Marshall Counties, Indiana.

WHEREAS, the State transportation agency, in consultation with responsible local officials, shall have the responsibility for proposing all official actions regarding the designation, or revision, of the Federal-aid highway systems, including the National Highway System (NHS), per the Code of Federal Regulations (23 CFR § 470.1109).

WHEREAS, responsible local officials in Elkhart County and the City of Goshen, Indiana, cooperated and provided input to the NHS revision process initiated by the Indiana Department of Transportation through the MACOG planning process; and

NOW, THEREFORE, BE IT RESOLVED, that the Policy Board of the Michiana Area Council of Governments approves the revised National Highway System in the MACOG four county planning region as indicated on the attached map and route listing, and authorizes its submittal to the Indiana Department of Transportation and the Federal Highway Administration.


RESOLVED THIS 14th Day of November, 2018

Michiana Area Council of Governments



David Wood, Policy Board Chair

NHS Revision - Elkhart County

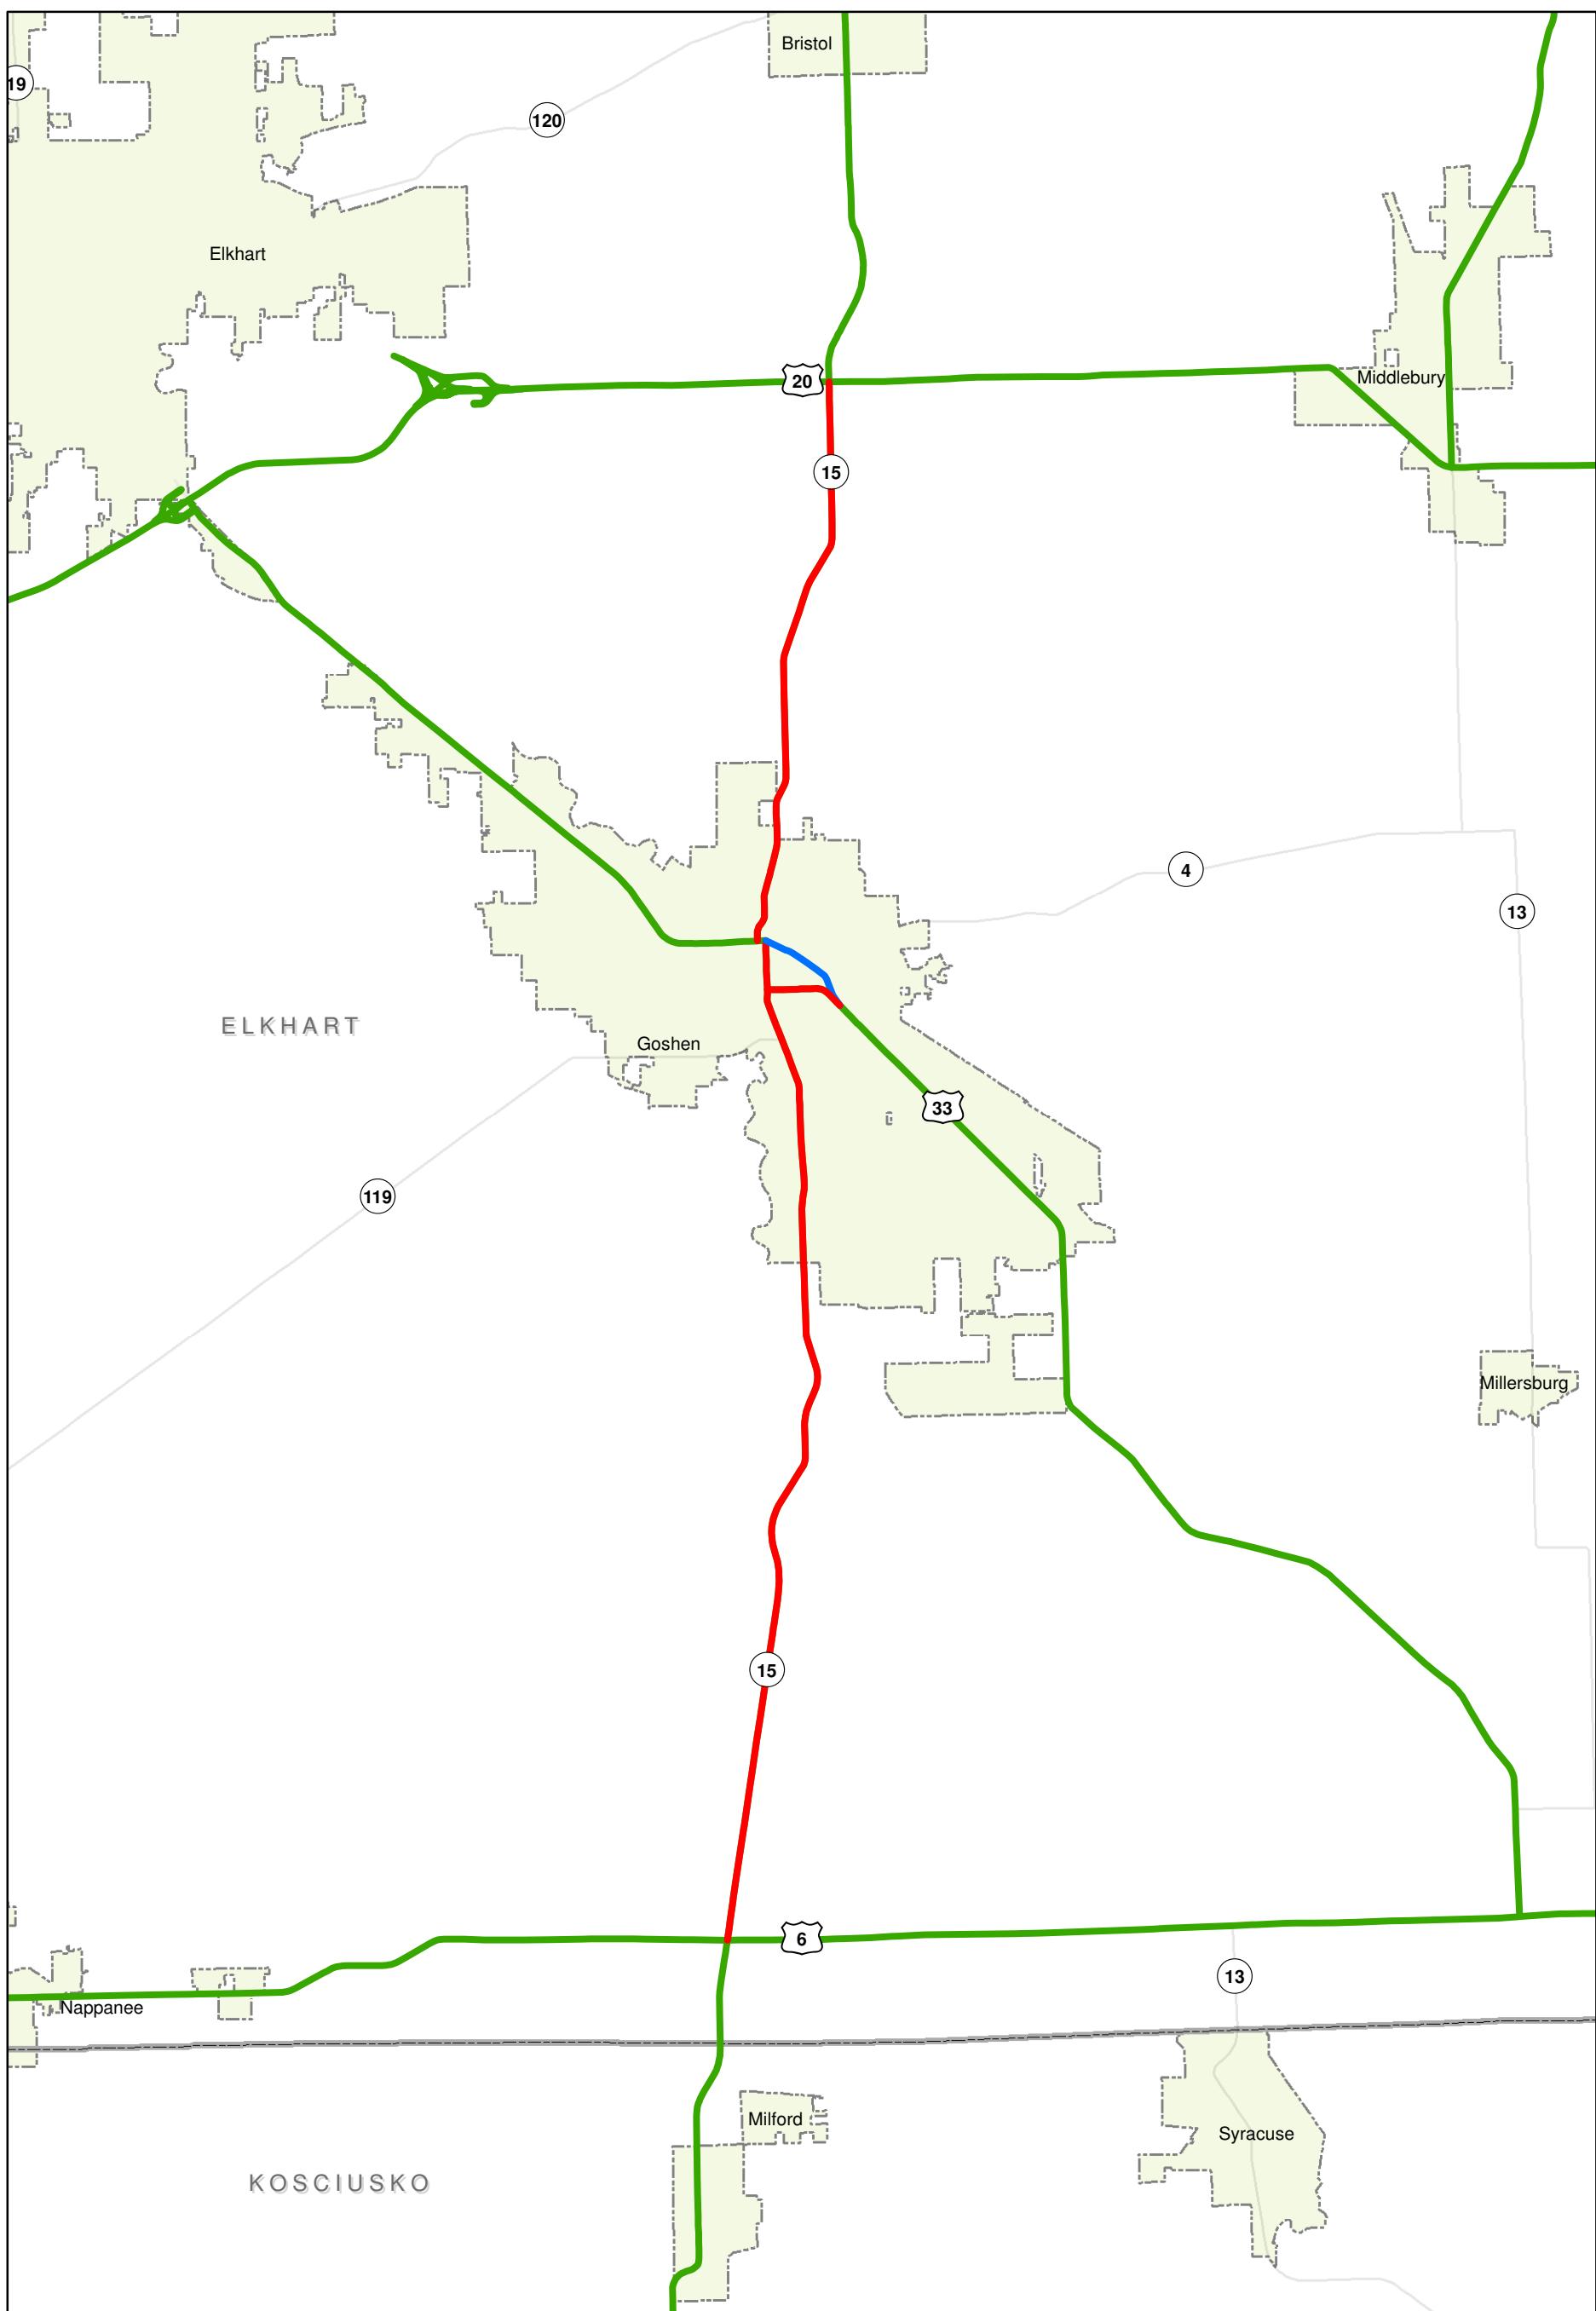

Legend

- Blue line: Add to NHS (US 33 Bypass)
- Red line: Remove from NHS
- Green line: Current NHS

